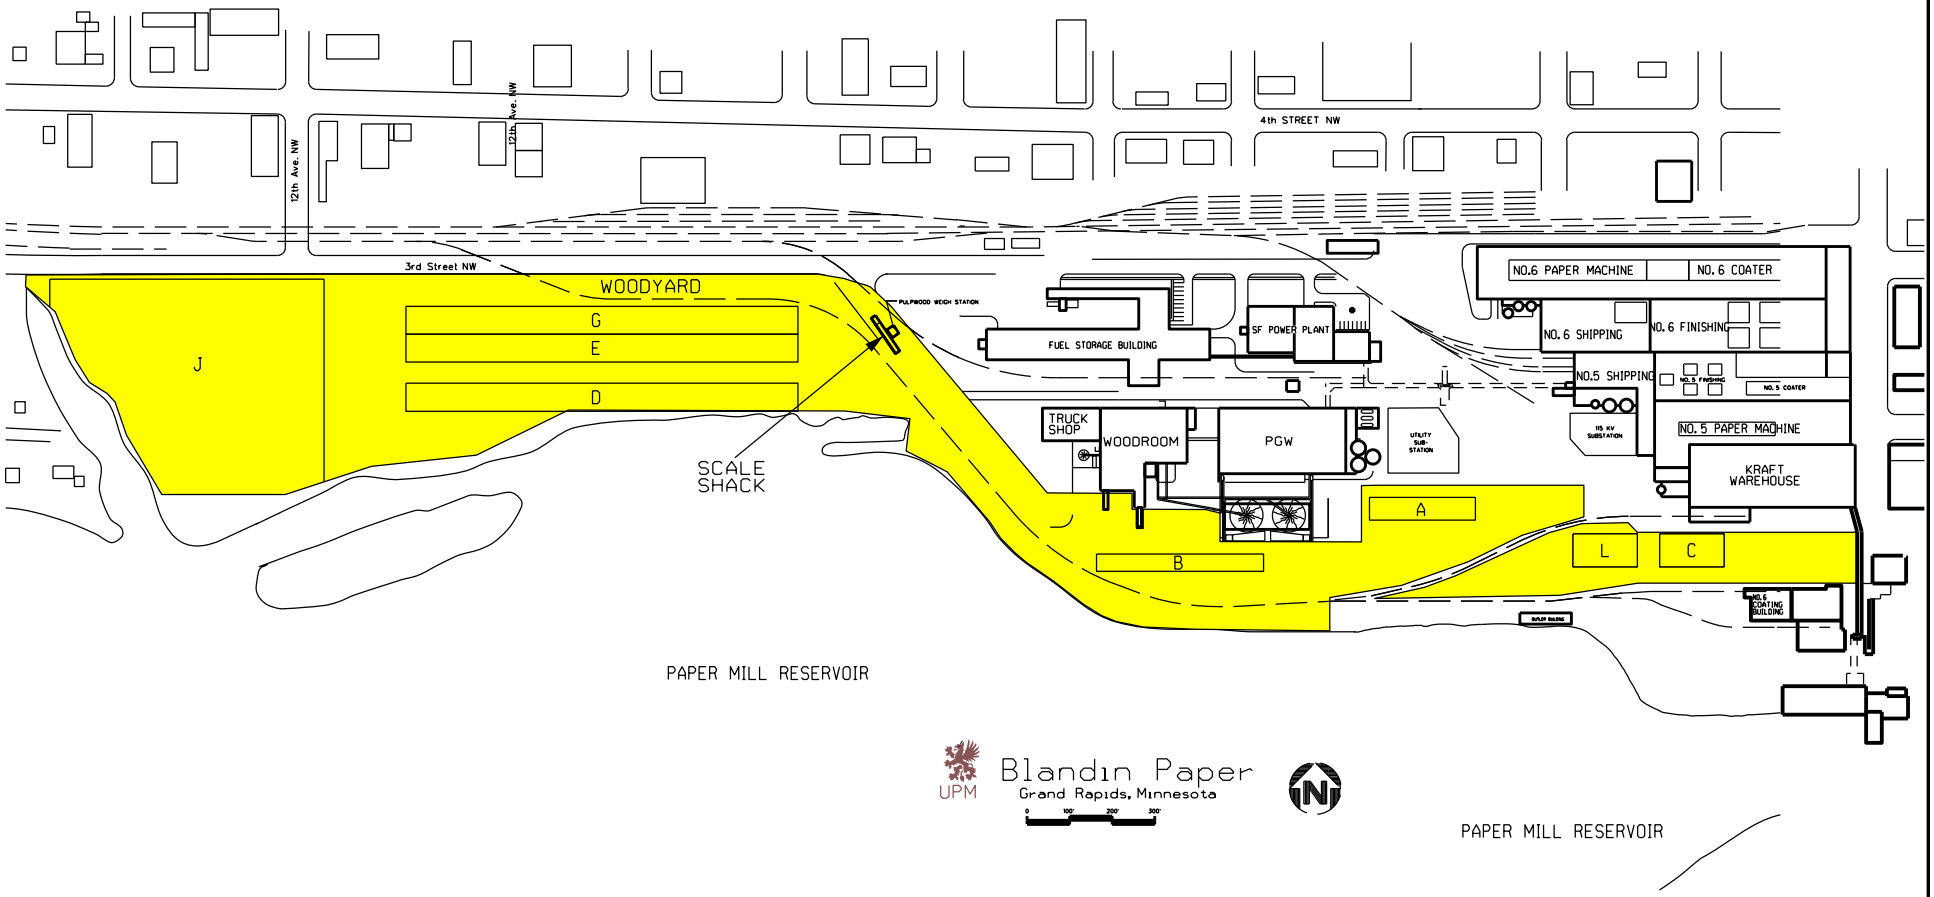

.883-12

REV.	DATE	DESCRIPTION	BY	CHK.	APP.	REFERENCE DWGS.	VENDOR
1	25JAN13	UPDATE YARD 2012 DEMO	EM	JB	JB		

UPM **BLANDIN PAPER** Grand Rapids, Minnesota

DRAWN:	LTP	DATE:	10/27/10
CHECKED:	JB	DATE:	10/27/10
APPROVED:	JB	DATE:	10/27/10
SCALE:	1" = 450' - 0"		

PROCESS AREA: PGW GENERAL

TITLE: YARD MAP

PROJECT NO.

TAG NO.

ALT. NO.

STATUS: AS-BUILT

DRAWING NO: A - 100 - CS - 0102 — SIZE — AREA NO. — DISCIPLINE — SEQUENCE NO.

SHEET 001 OF 001

REV. 1